


PROJECT:  
IZZUDHEEN OFFICE

PROJ. REF:  
SCALE: AS GIVEN  
ARCHITECT:  
ENGINEER:  
DRAWN:  
CHECKED:  
DATE: 09.04.2025

AMENDMENTS		
Issue	Date	Description

DWG NO: A-01/05

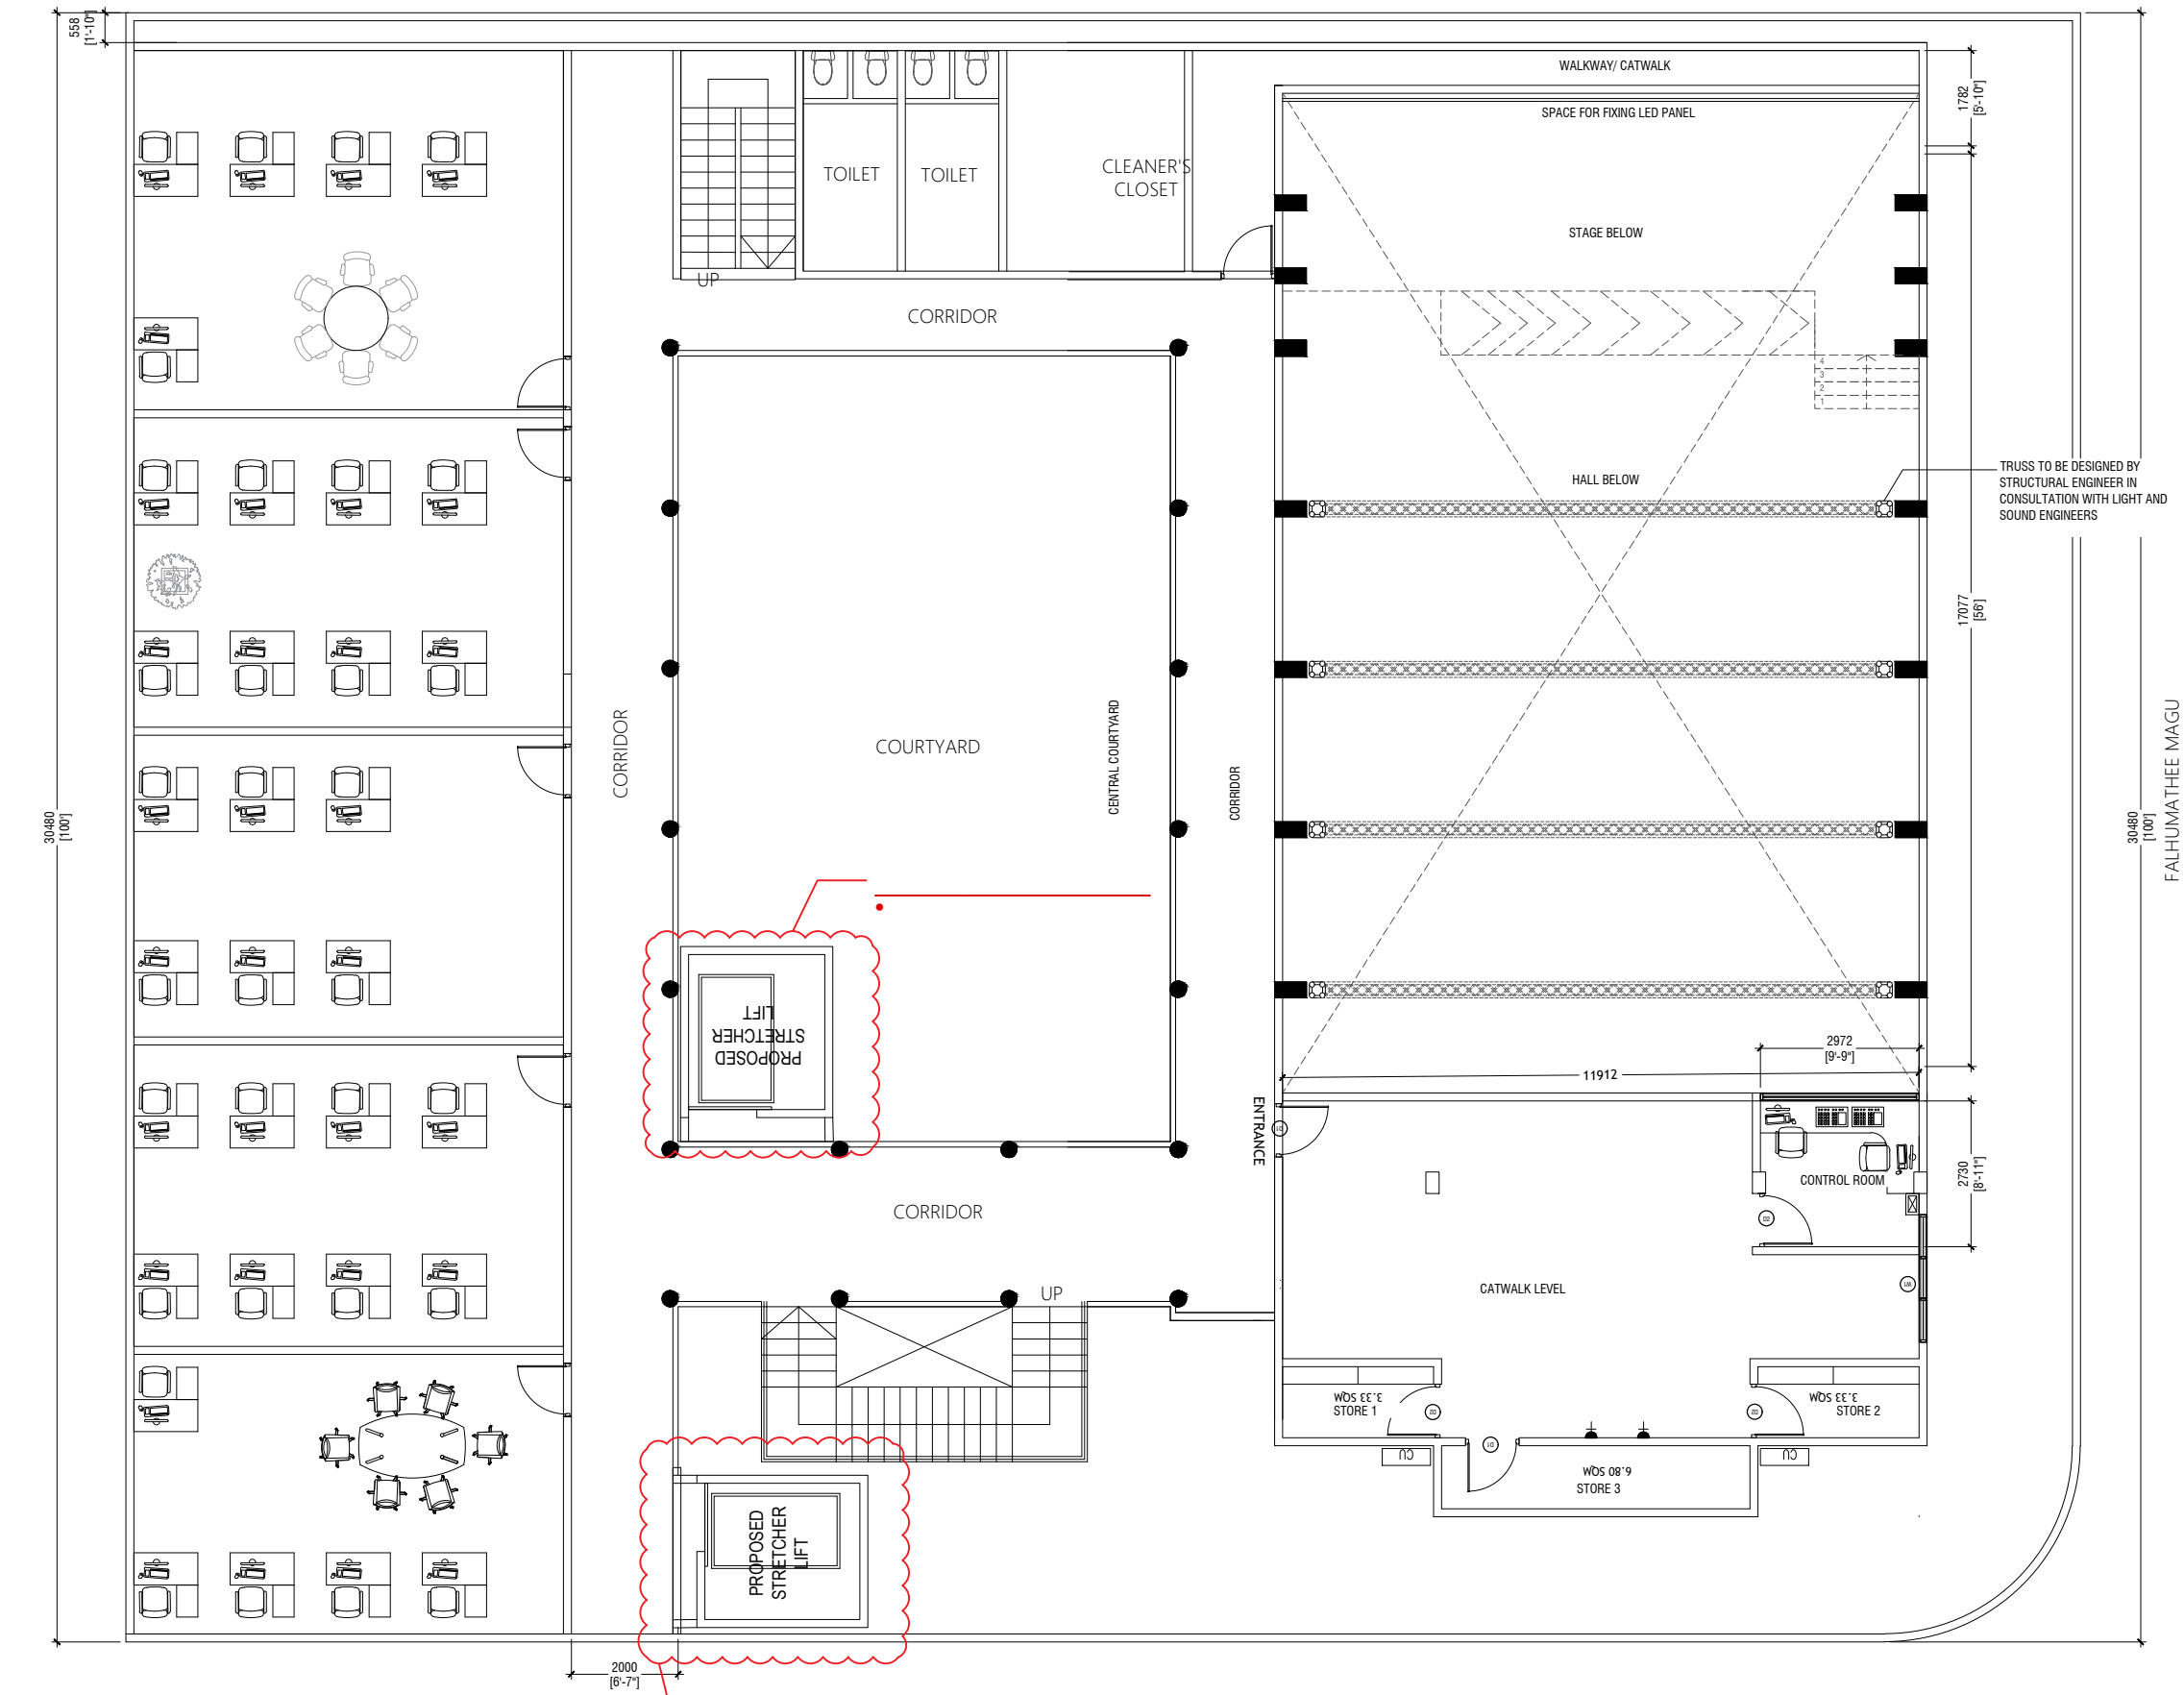

**FIRST FLOOR EXISTING FLOOR PLAN**  
SCALE 1:100

- PROPOSED LOCATION**
- FOR THIS OPTION THE STORE AND THE SMALL ROOM LOCATED AT THE GROUND FLOOR NEEDS TO BE DEMOLISHED
  - CONTRACTORS SCOPE SHALL INCLUDE SUPPLY AND INSTALLATION OF THE LIFT, AS WELL AS THE SURVEYING, DESIGN AND CONSTRUCTION OF THE LIFT STRUCTURE

**NOTE:**  
**THIS IS NOT AN AS-BUILT DRAWING**  
**DIMENSIONS AND ROOMS SHOWN SHOULD BE CHECKED AND CONFIRMED ON SITE**

**PHYSICAL FACILITIES DEVELOPMENT SECTION**  
MINISTRY OF EDUCATION  
REPUBLIC OF MALDIVES


**PROJECT:**  
IZZUDHEEN OFFICE

**PROJ. REF:**  
SCALE: AS GIVEN

**ARCHITECT:**  
ENGINEER:  
DRAWN:  
CHECKED:  
DATE: 09.04.2025

AMENDMENTS		
Issue	Date	Description

DWG NO: A-02/05

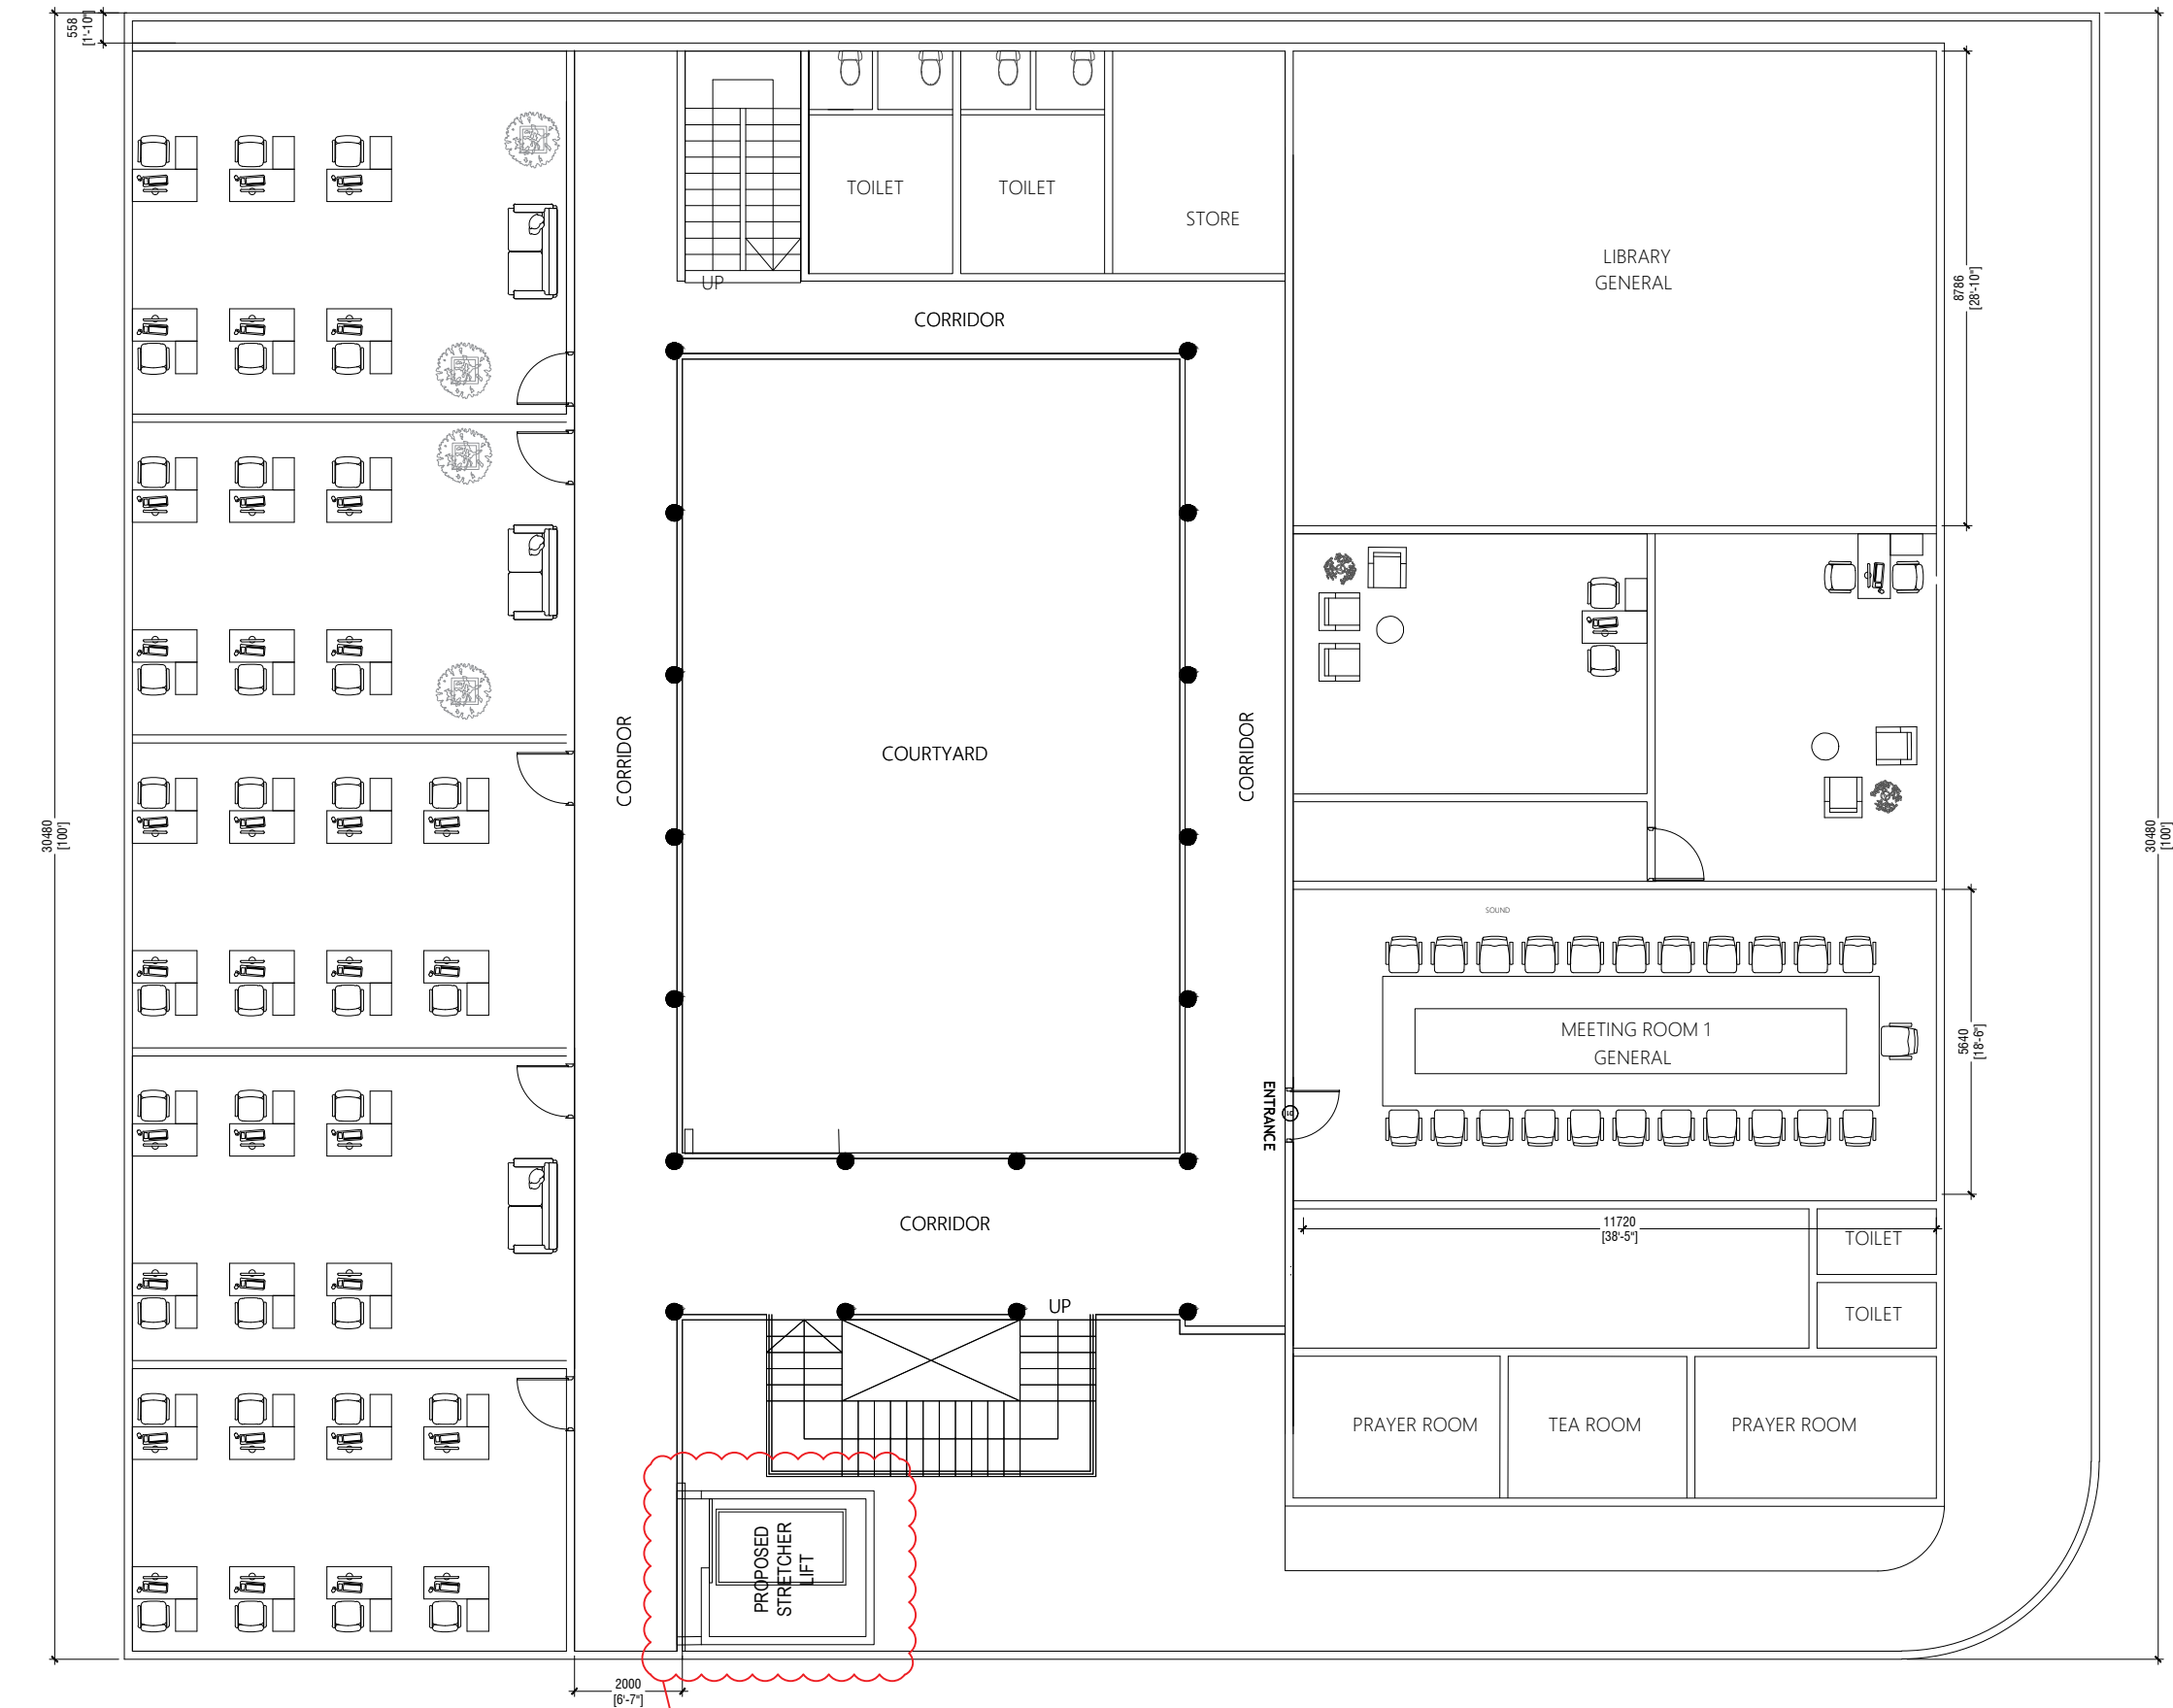

## SECOND FLOOR EXISTING FLOOR PLAN

SCALE 1:100



### PROPOSED LOCATION

- FOR THIS OPTION THE STORE AND THE SMALL ROOM LOCATED AT THE GROUND FLOOR NEEDS TO BE DEMOLISHED
- CONTRACTORS SCOPE SHALL INCLUDE SUPPLY AND INSTALLATION OF THE LIFT, AS WELL AS THE SURVEYING, DESIGN AND CONSTRUCTION OF THE LIFT STRUCTURE

### NOTE:


**THIS IS NOT AN AS-BUILT DRAWING  
DIMENSIONS AND ROOMS SHOWN SHOULD BE CHECKED AND CONFIRMED ON SITE**



PROJECT: IZZUDHEEN OFFICE		
PROJ. REF:		
SCALE: AS GIVEN		
ARCHITECT:		
ENGINEER:		
DRAWN:		
CHECKED:		
DATE: 09.04.2025		

AMENDMENTS		
Issue	Date	Description

DWG NO: A-03/05

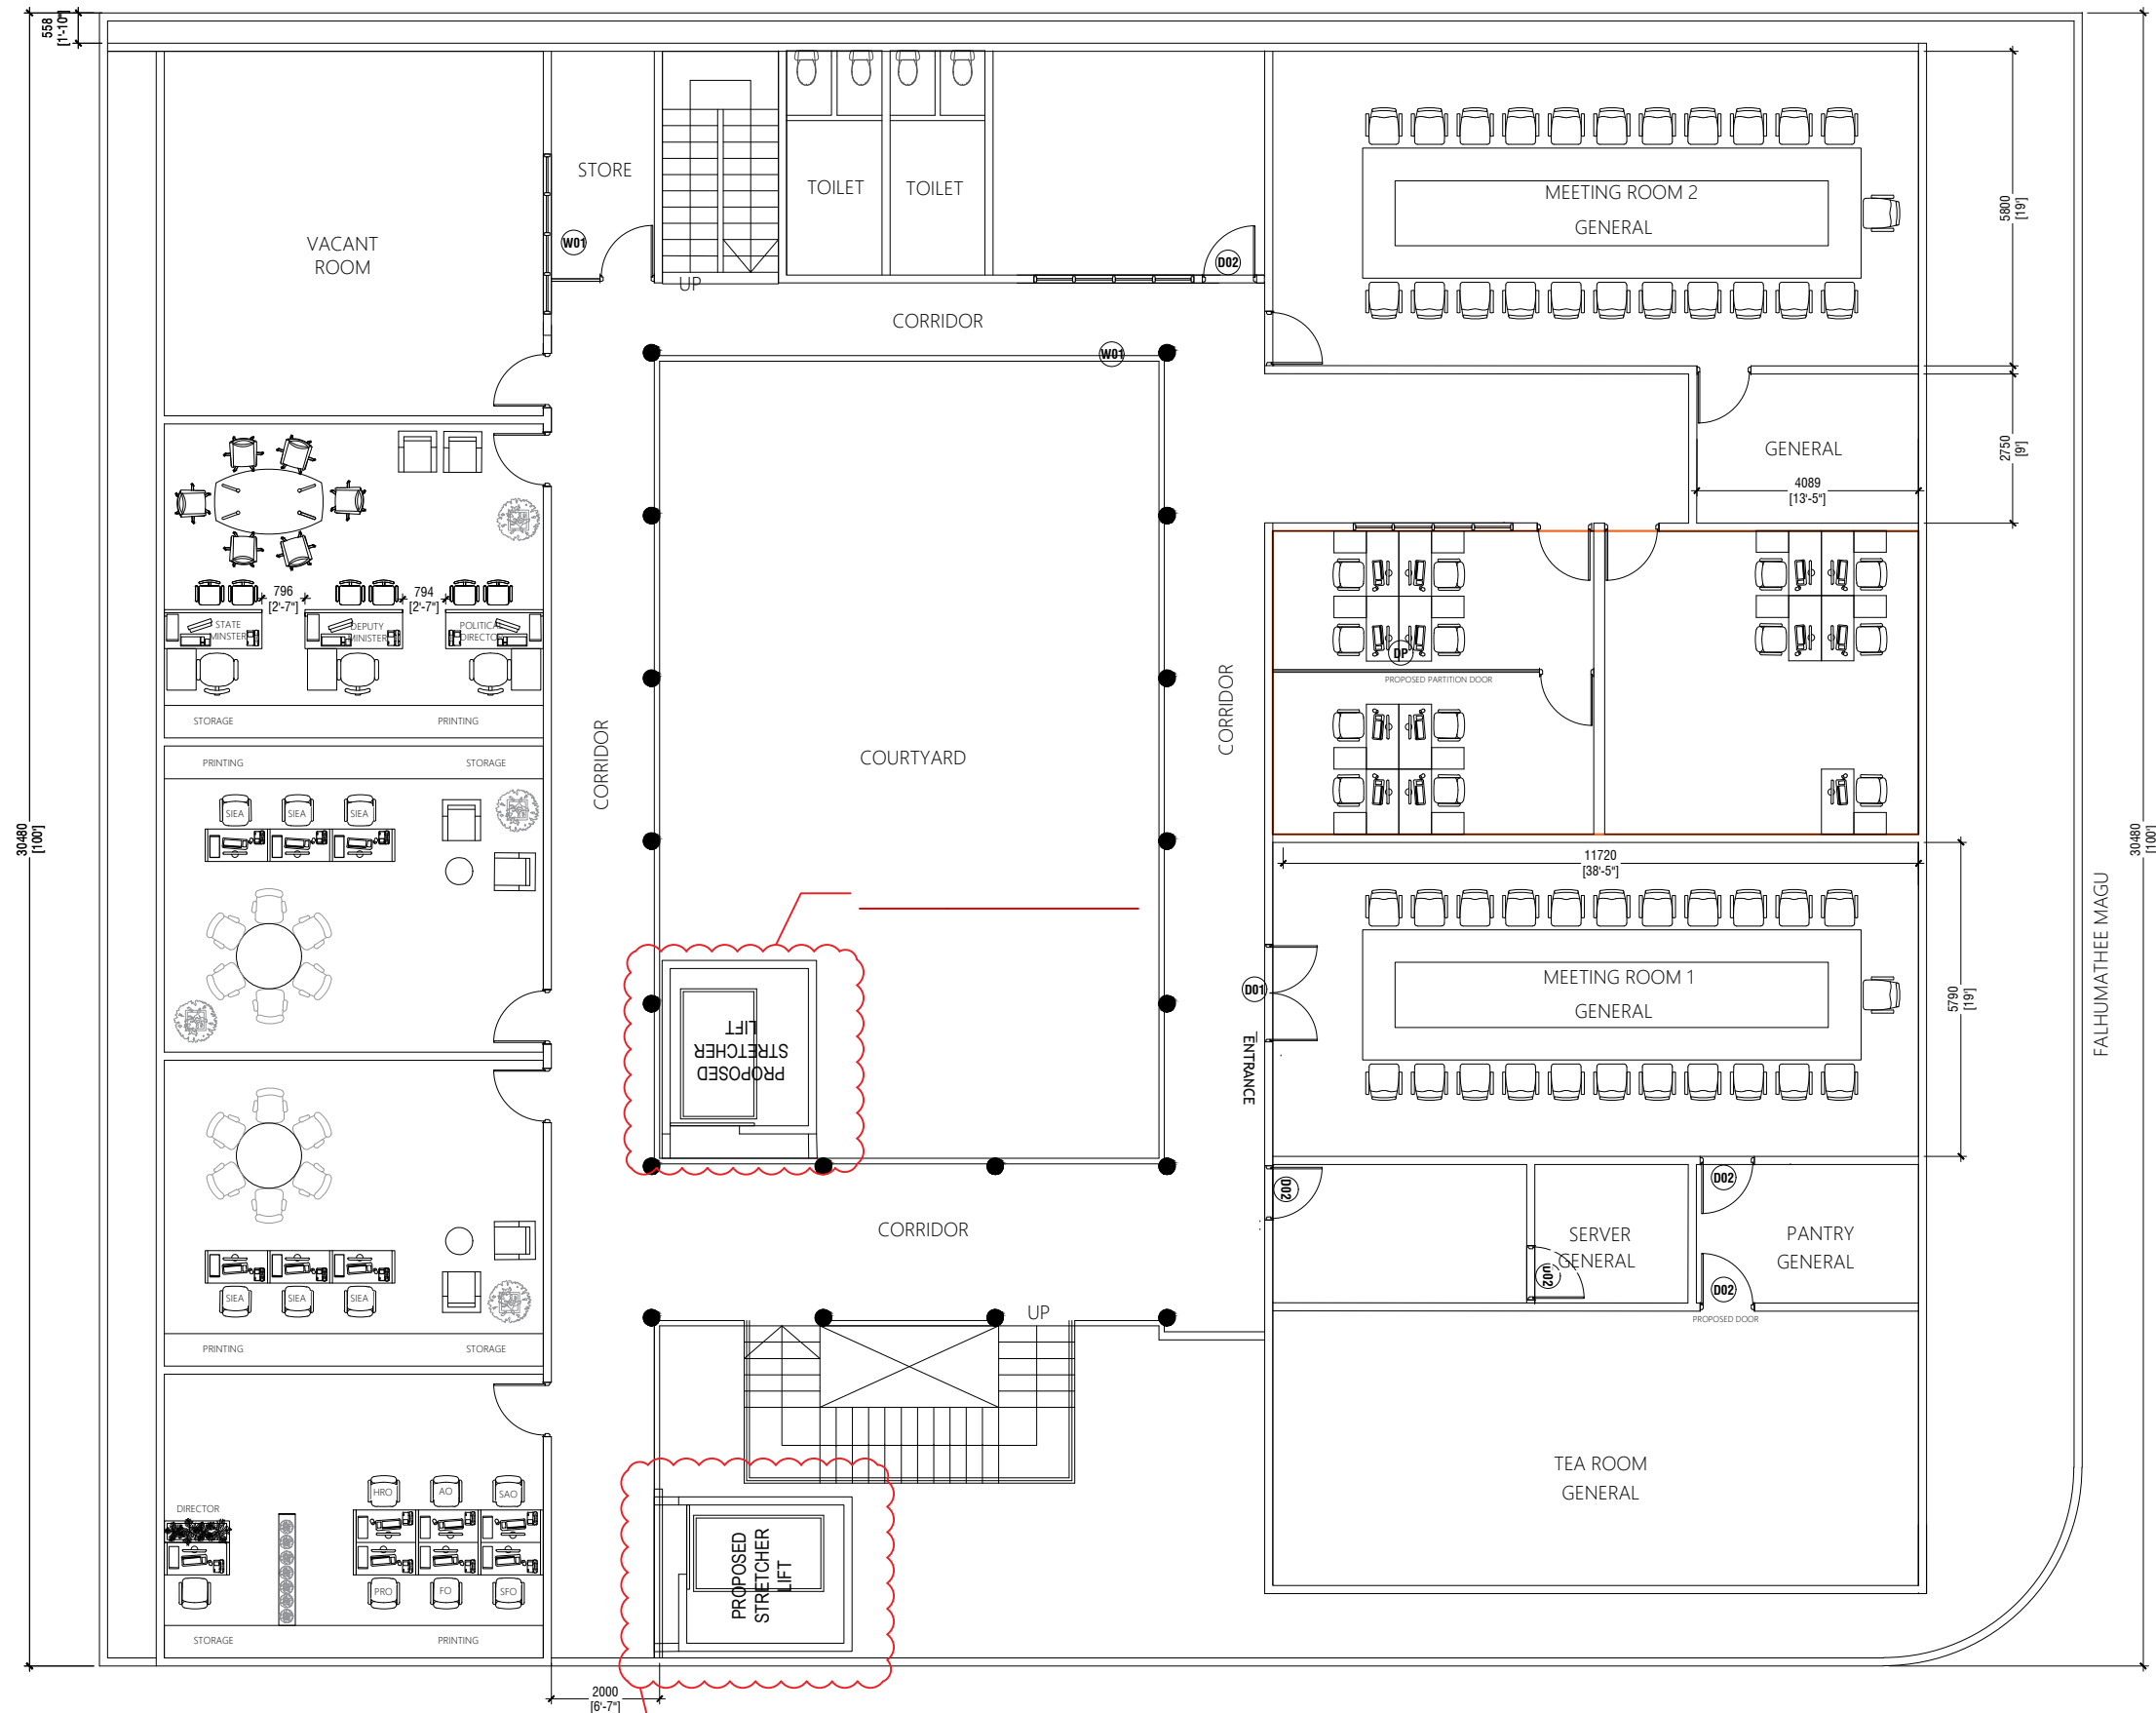

### THIRD FLOOR EXISTING FLOOR PLAN

SCALE 1:100



#### PROPOSED LOCATION

- FOR THIS OPTION THE STORE AND THE SMALL ROOM LOCATED AT THE GROUND FLOOR NEEDS TO BE DEMOLISHED
- CONTRACTORS SCOPE SHALL INCLUDE SUPPLY AND INSTALLATION OF THE LIFT, AS WELL AS THE SURVEYING, DESIGN AND CONSTRUCTION OF THE LIFT STRUCTURE

**NOTE:**  
**THIS IS NOT AN AS-BUILT DRAWING**  
**DIMENSIONS AND ROOMS SHOWN SHOULD BE CHECKED AND CONFIRMED ON SITE**




PROJECT:  
**IZZUDHEEN OFFICE**

PROJ. REF:  
SCALE: AS GIVEN  
ARCHITECT:  
ENGINEER:  
DRAWN:  
CHECKED:  
DATE: 09.04.2025

AMENDMENTS		
Issue	Date	Description

DWG NO: **A-04/05**

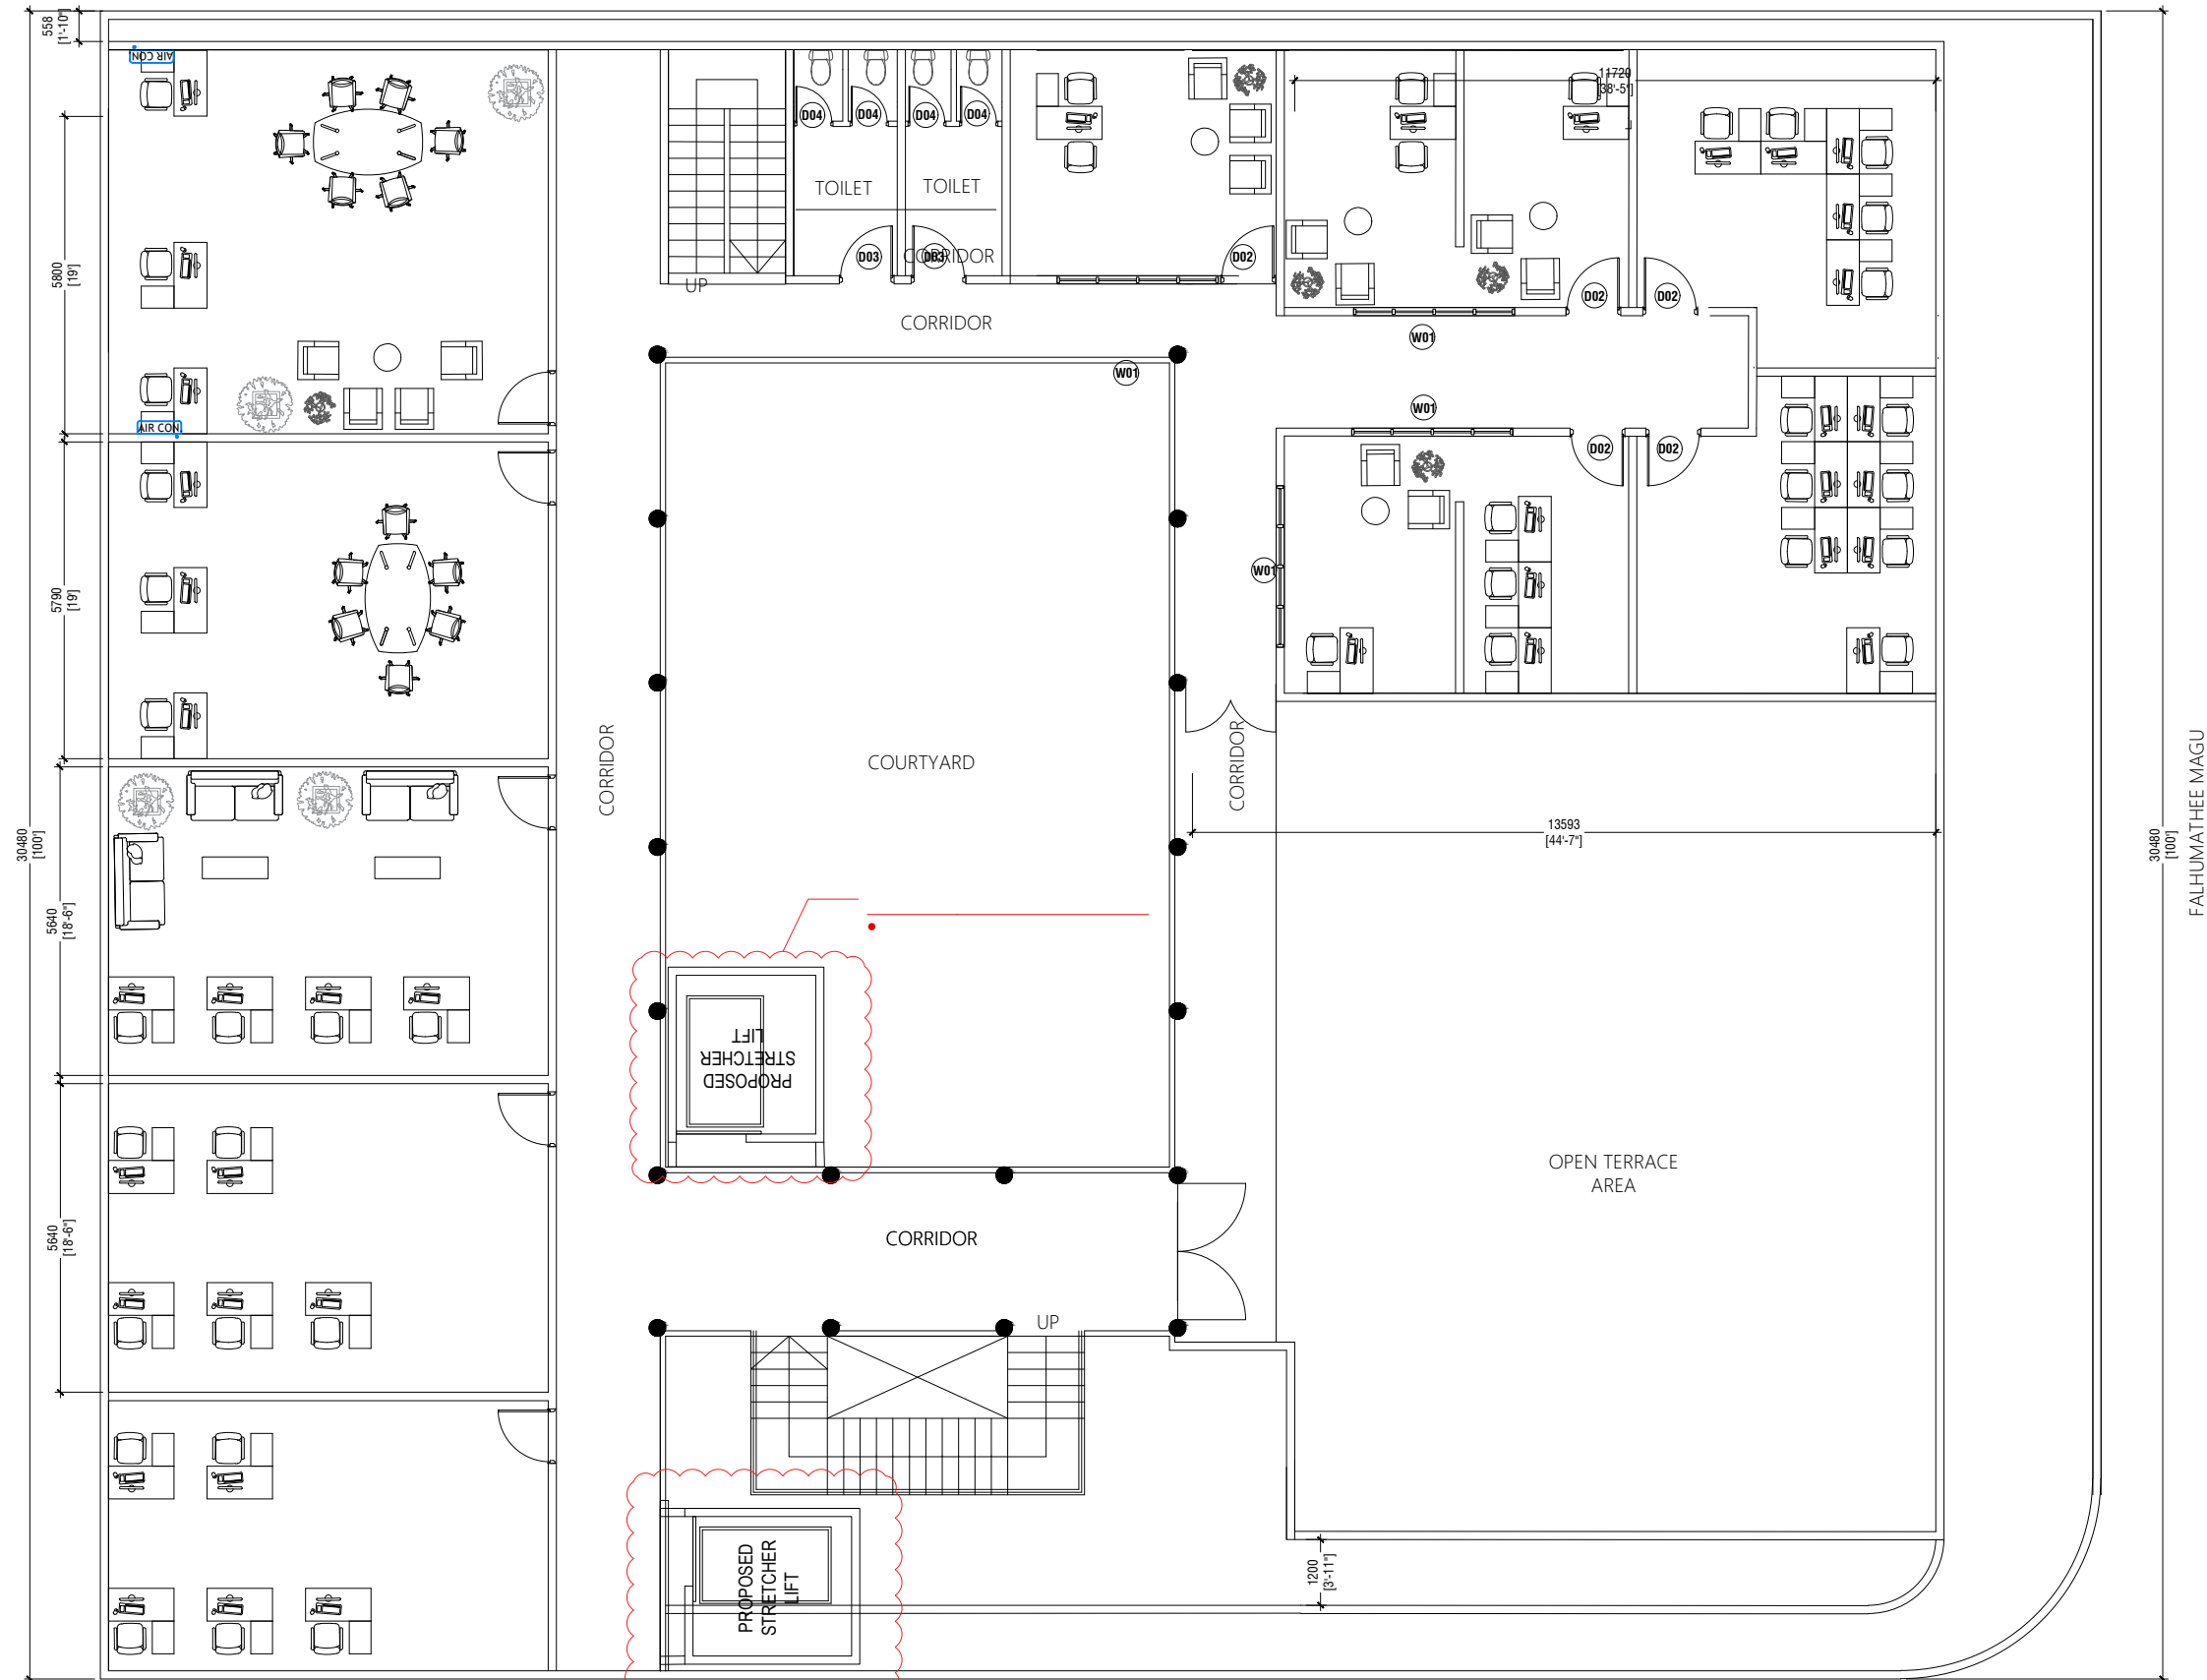

#### FOURTH FLOOR EXISTING FLOOR PLAN

SCALE 1:100



#### PROPOSED LOCATION

- FOR THIS OPTION THE STORE AND THE SMALL ROOM LOCATED AT THE GROUND FLOOR NEEDS TO BE DEMOLISHED
- CONTRACTORS SCOPE SHALL INCLUDE SUPPLY AND INSTALLATION OF THE LIFT, AS WELL AS THE SURVEYING, DESIGN AND CONSTRUCTION OF THE LIFT STRUCTURE

#### NOTE:

**THIS IS NOT AN AS-BUILT DRAWING  
DIMENSIONS AND ROOMS SHOWN SHOULD BE CHECKED AND CONFIRMED ON SITE**



PROJECT :		
IZZUDHEEN OFFICE		
PROJ. REF:		
SCALE : AS GIVEN		
ARCHITECT :		
ENGINEER :		
DRAWN :		
CHECKED :		
DATE : 09.04.2025		

AIMENDMENTS		
Issue	Date	Description

DWG NO : A-05/05