

GROUND FLOOR EXISTING FLOOR PLAN

SCALE 1:100



PROPOSED LOCATION

- FOR THIS OPTION THE STORE AND THE SMALL ROOM LOCATED AT THE GROUND FLOOR NEEDS TO BE DEMOLISHED
- CONTRACTORS SCOPE SHALL INCLUDE SUPPLY AND INSTALLATION OF THE LIFT, AS WELL AS THE SURVEYING, DESIGN AND CONSTRUCTION OF THE LIFT STRUCTURE


NOTE:
THIS IS NOT AN AS-BUILT DRAWING
DIMENSIONS AND ROOMS SHOWN SHOULD BE CHECKED AND CONFIRMED ON SITE



PROJECT:		IZZUDHEEN OFFICE
PROJ. REF:		
SCALE:		AS GIVEN
ARCHITECT:		
ENGINEER:		
DRAWN:		
CHECKED:		
DATE:		09.04.2025

AMMENDMENTS		
Issue	Date	Description

DWG NO: A-01/05

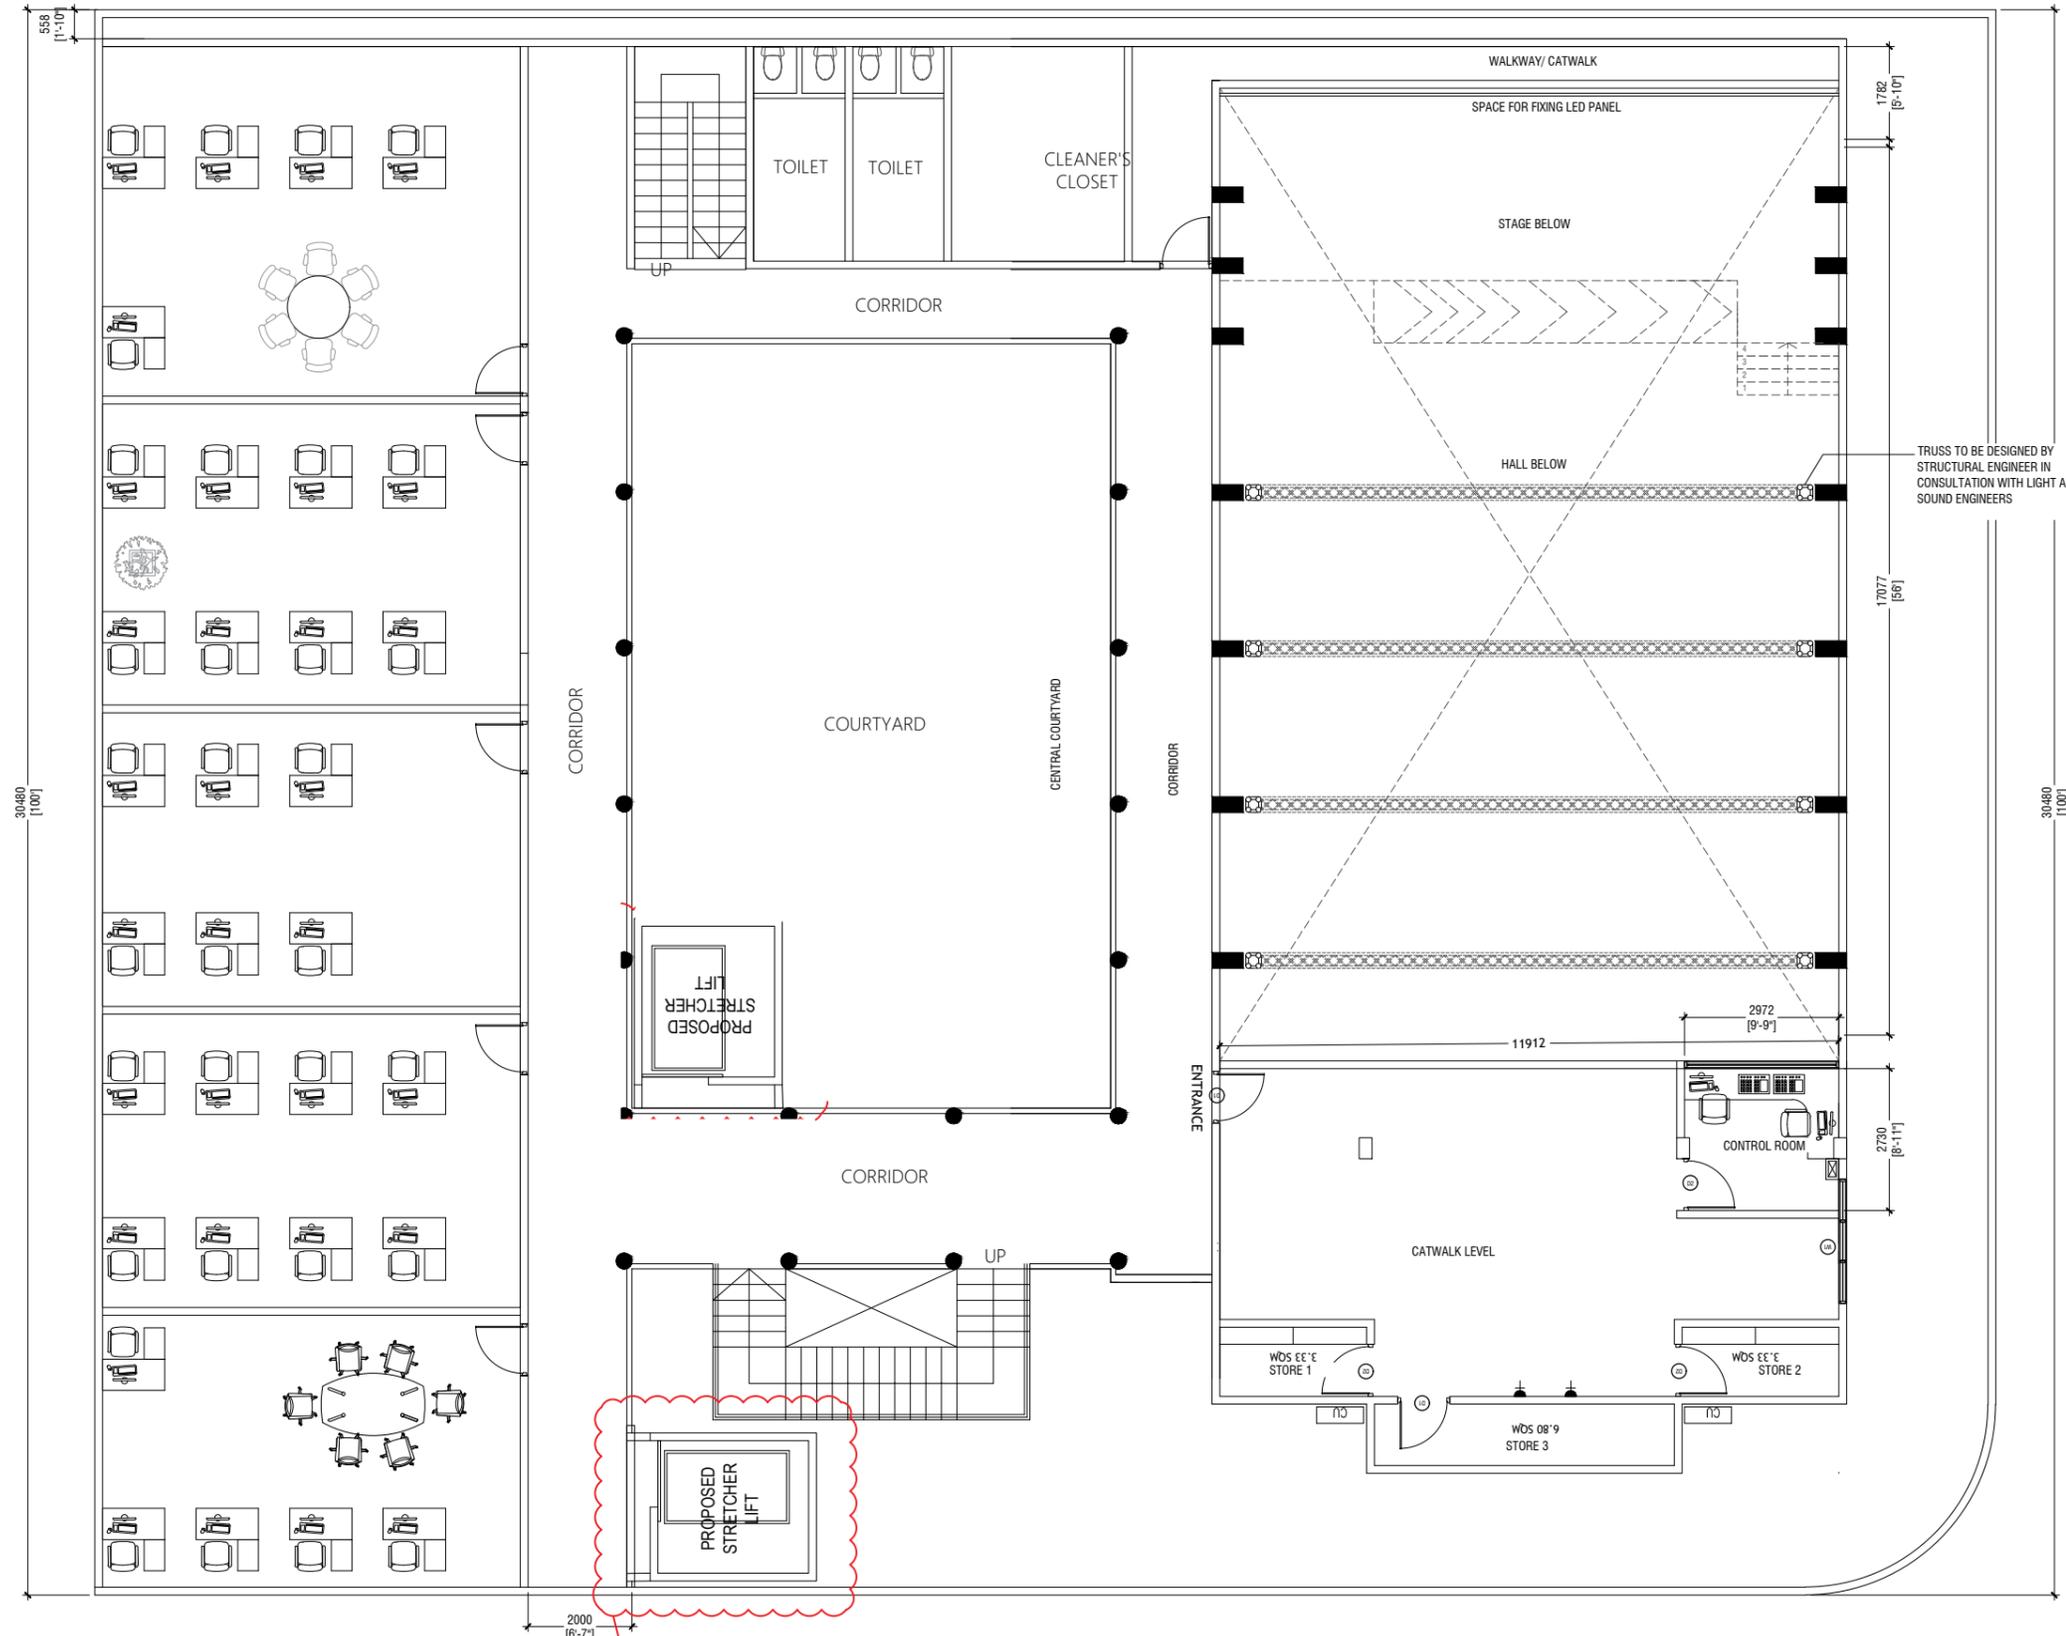

FIRST FLOOR EXISTING FLOOR PLAN

SCALE 1:100



PROPOSED LOCATION

- FOR THIS OPTION THE STORE AND THE SMALL ROOM LOCATED AT THE GROUND FLOOR NEEDS TO BE DEMOLISHED
- CONTRACTORS SCOPE SHALL INCLUDE SUPPLY AND INSTALLATION OF THE LIFT, AS WELL AS THE SURVEYING, DESIGN AND CONSTRUCTION OF THE LIFT STRUCTURE

NOTE:
THIS IS NOT AN AS-BUILT DRAWING
DIMENSIONS AND ROOMS SHOWN SHOULD BE CHECKED AND CONFIRMED ON SITE


TRUSS TO BE DESIGNED BY STRUCTURAL ENGINEER IN CONSULTATION WITH LIGHT AND SOUND ENGINEERS



PROJECT:		IZZUDHEEN OFFICE
PROJ. REF:		
SCALE:		AS GIVEN
ARCHITECT:		
ENGINEER:		
DRAWN:		
CHECKED:		
DATE:		09.04.2025

AMMENDMENTS		
Issue	Date	Description

DWG NO: A-02/05

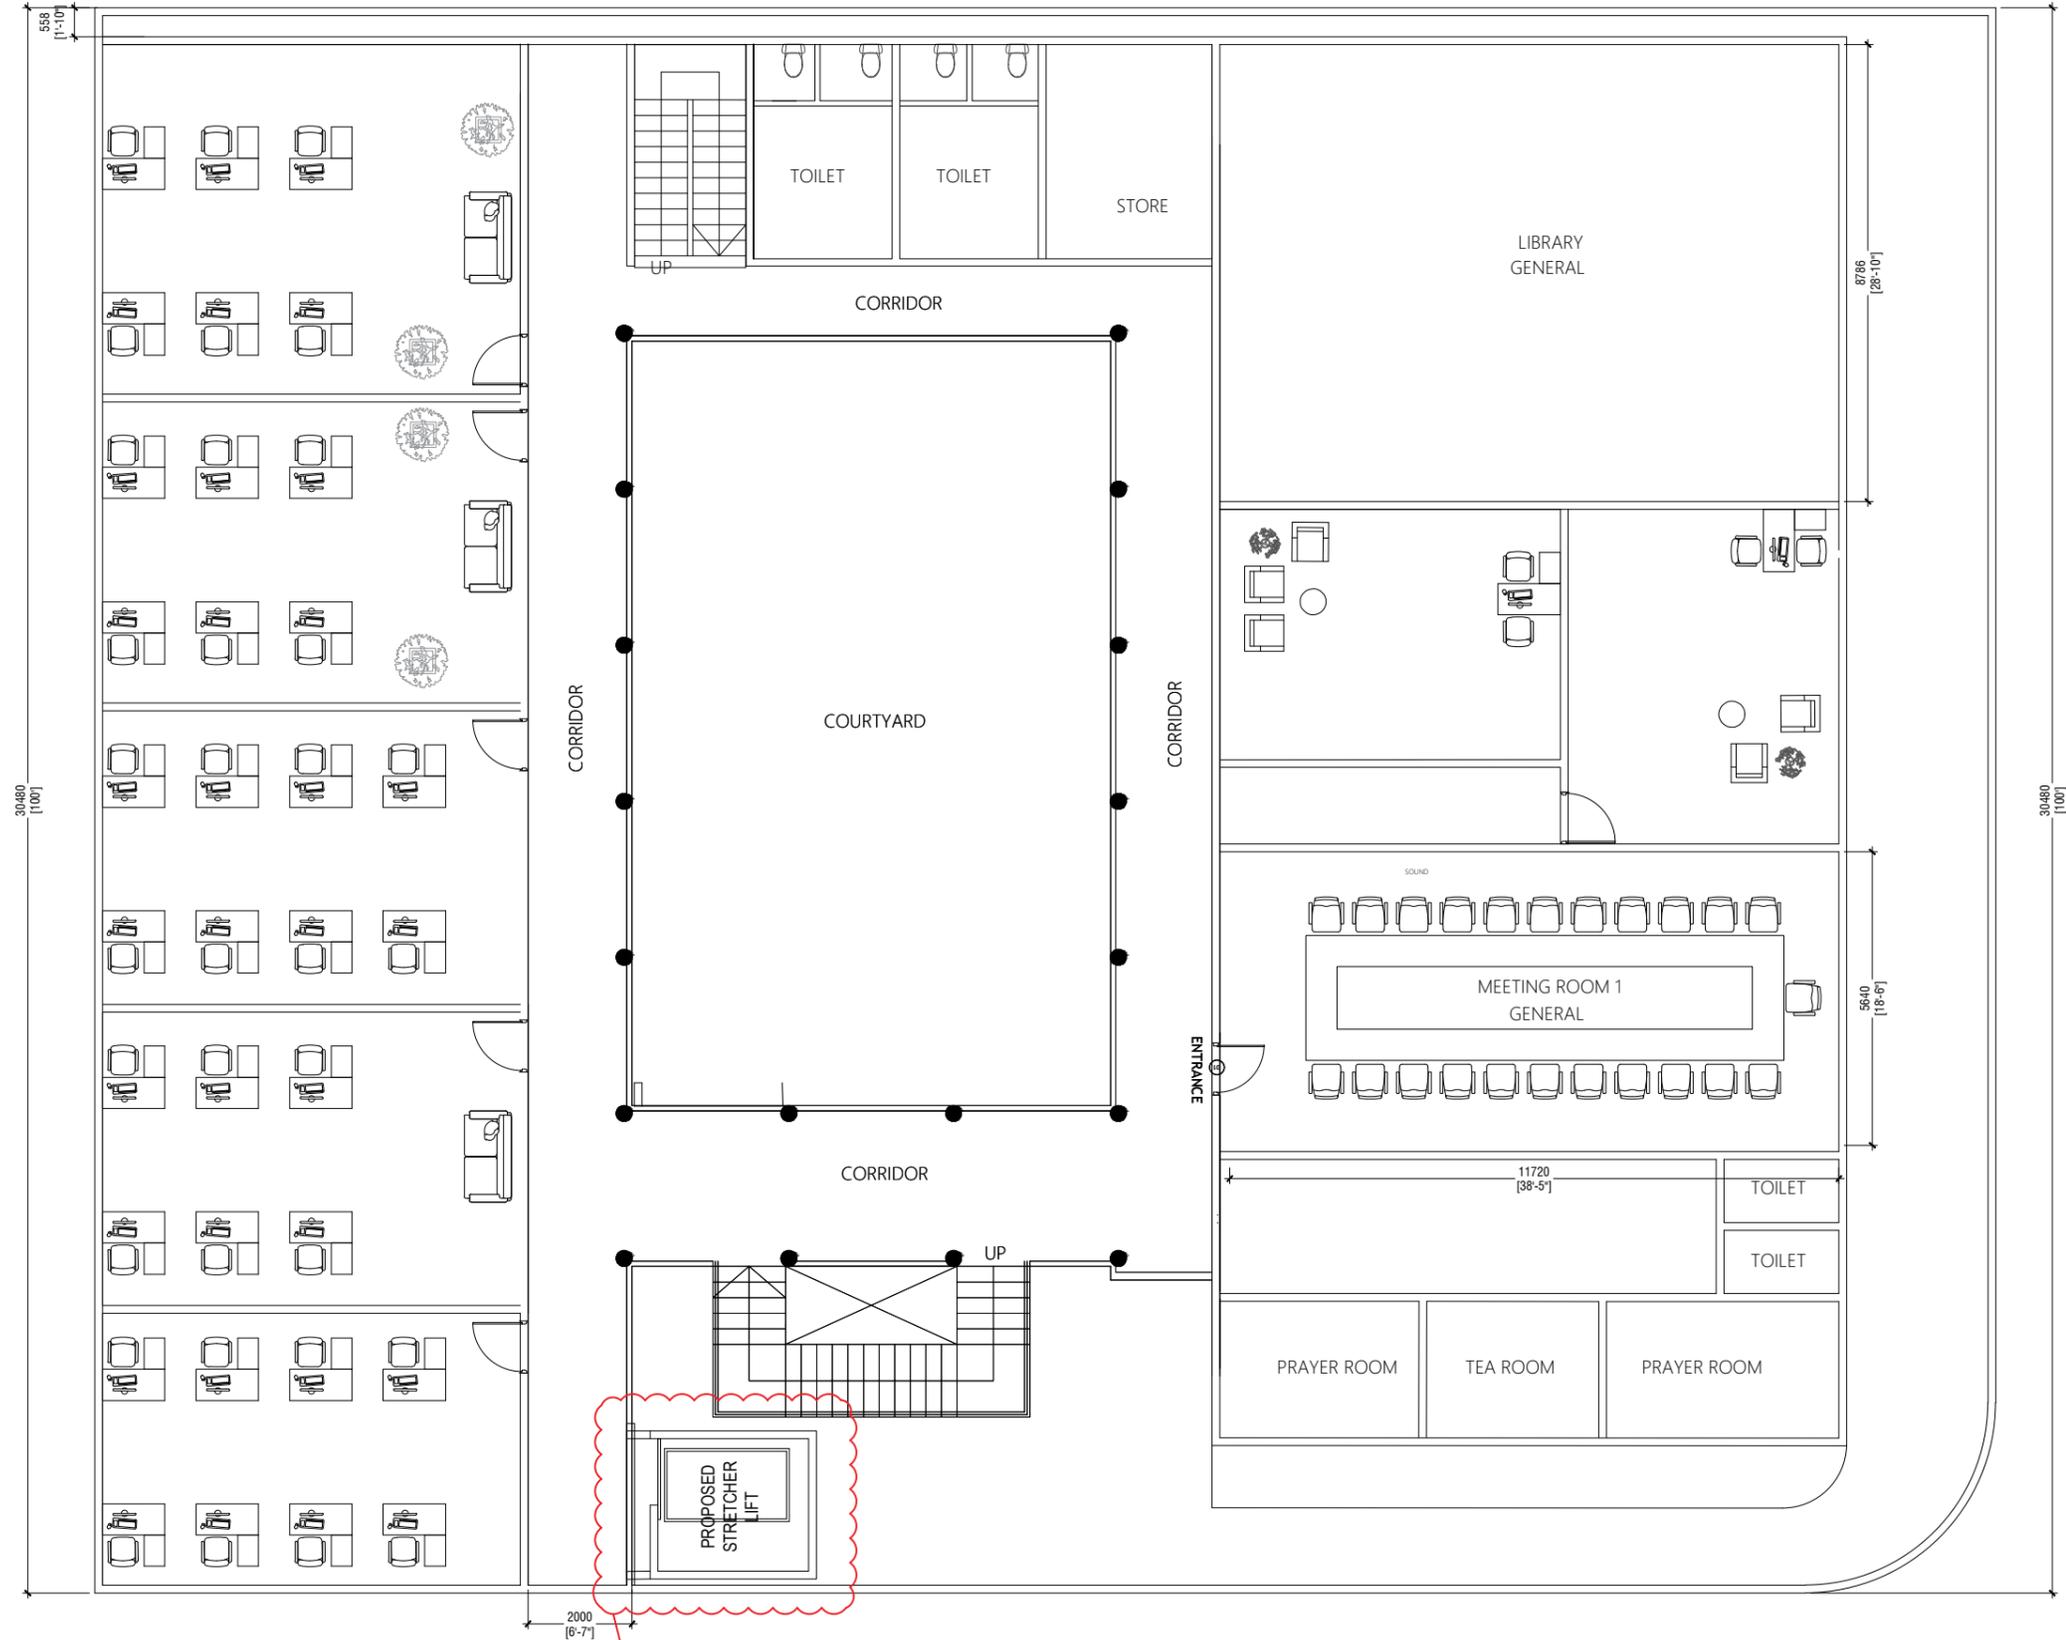

SECOND FLOOR EXISTING FLOOR PLAN

SCALE 1:100



PROPOSED LOCATION

- FOR THIS OPTION THE STORE AND THE SMALL ROOM LOCATED AT THE GROUND FLOOR NEEDS TO BE DEMOLISHED
- CONTRACTORS SCOPE SHALL INCLUDE SUPPLY AND INSTALLATION OF THE LIFT, AS WELL AS THE SURVEYING, DESIGN AND CONSTRUCTION OF THE LIFT STRUCTURE


NOTE:
THIS IS NOT AN AS-BUILT DRAWING
DIMENSIONS AND ROOMS SHOWN SHOULD BE CHECKED AND CONFIRMED ON SITE



PROJECT:		IZZUDHEEN OFFICE
PROJ. REF:		
SCALE:		AS GIVEN
ARCHITECT:		
ENGINEER:		
DRAWN:		
CHECKED:		
DATE:		09.04.2025

AMMENDMENTS		
Issue	Date	Description

DWG NO: A-03/05

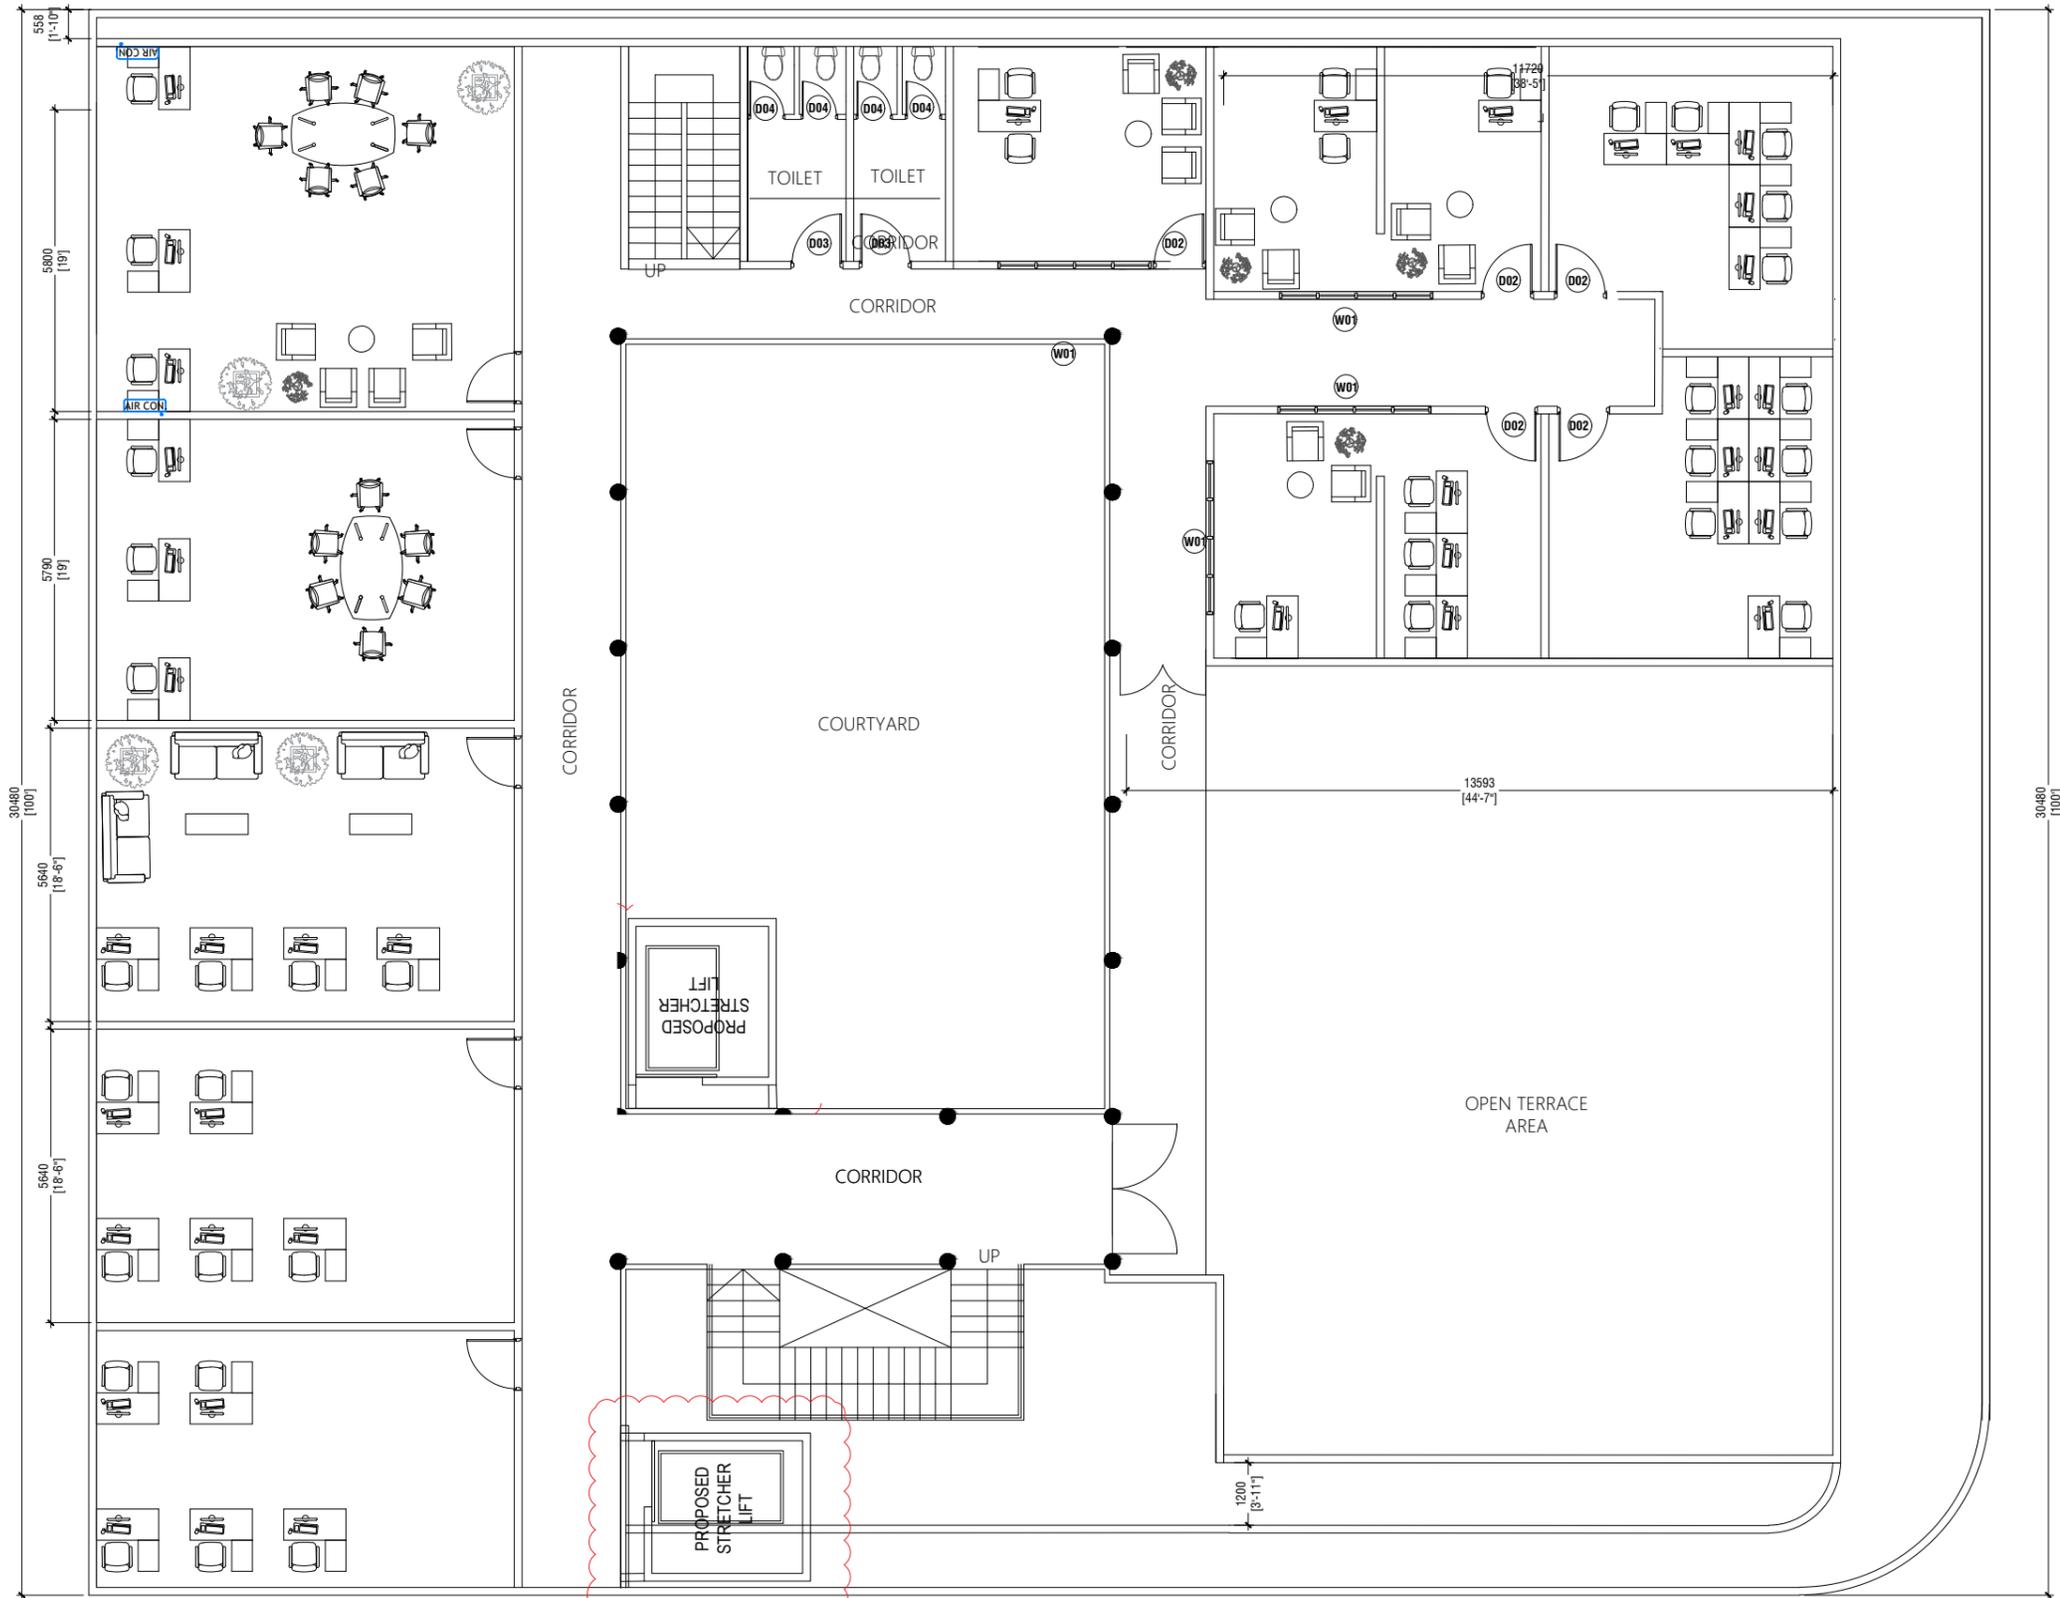

FOURTH FLOOR EXISTING FLOOR PLAN

SCALE 1:100



PROPOSED LOCATION

- FOR THIS OPTION THE STORE AND THE SMALL ROOM LOCATED AT THE GROUND FLOOR NEEDS TO BE DEMOLISHED
- CONTRACTORS SCOPE SHALL INCLUDE SUPPLY AND INSTALLATION OF THE LIFT, AS WELL AS THE SURVEYING, DESIGN AND CONSTRUCTION OF THE LIFT STRUCTURE

NOTE:
THIS IS NOT AN AS-BUILT DRAWING
DIMENSIONS AND ROOMS SHOWN SHOULD BE CHECKED AND CONFIRMED ON SITE



PROJECT:		IZZUDHEEN OFFICE
PROJ. REF:		
SCALE:		AS GIVEN
ARCHITECT:		
ENGINEER:		
DRAWN:		
CHECKED:		
DATE:		09.04.2025

AMMENDMENTS		
Issue	Date	Description

DWG NO: A-05/05